


PROPOSED 8" WATER

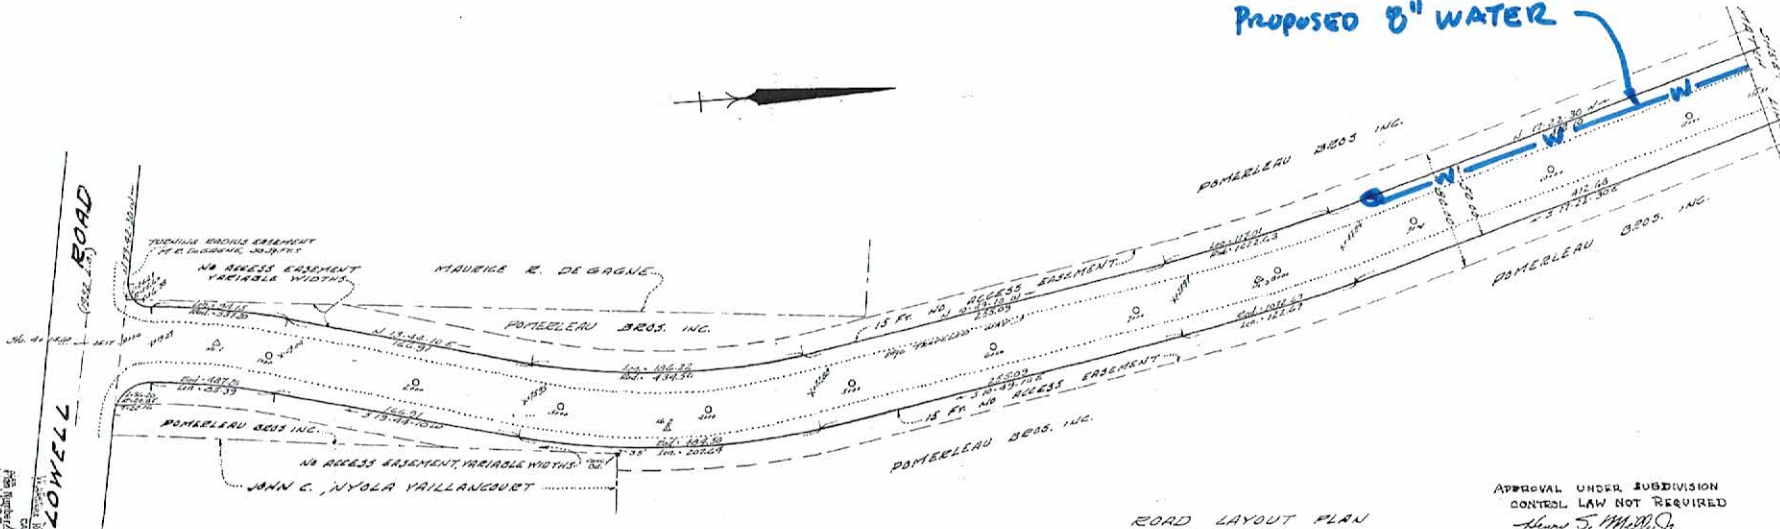

92 R

1985000  
APR 11 1978  
RECEIVED  
TOWN OF GROTON  
RECORDS DEPARTMENT  
509 A

RICHARD L. MCELINKEY  
AUGUST 1, 1975



ROAD LAYOUT PLAN  
IN  
GROTON, MASS.  
LAID OUT FOR THE  
TOWN OF GROTON  
SCALE 1/4" = 40 FT.


APPROVAL UNDER SUBDIVISION  
CONTROL LAW NOT REQUIRED  
Henry J. Mills, Jr.  
Douglas L. James  
Joseph C. Shinn

SHEET 1 of 5

March 30, 1976

PRIVATE WAY-GROTON

PROPOSED 8" WATER

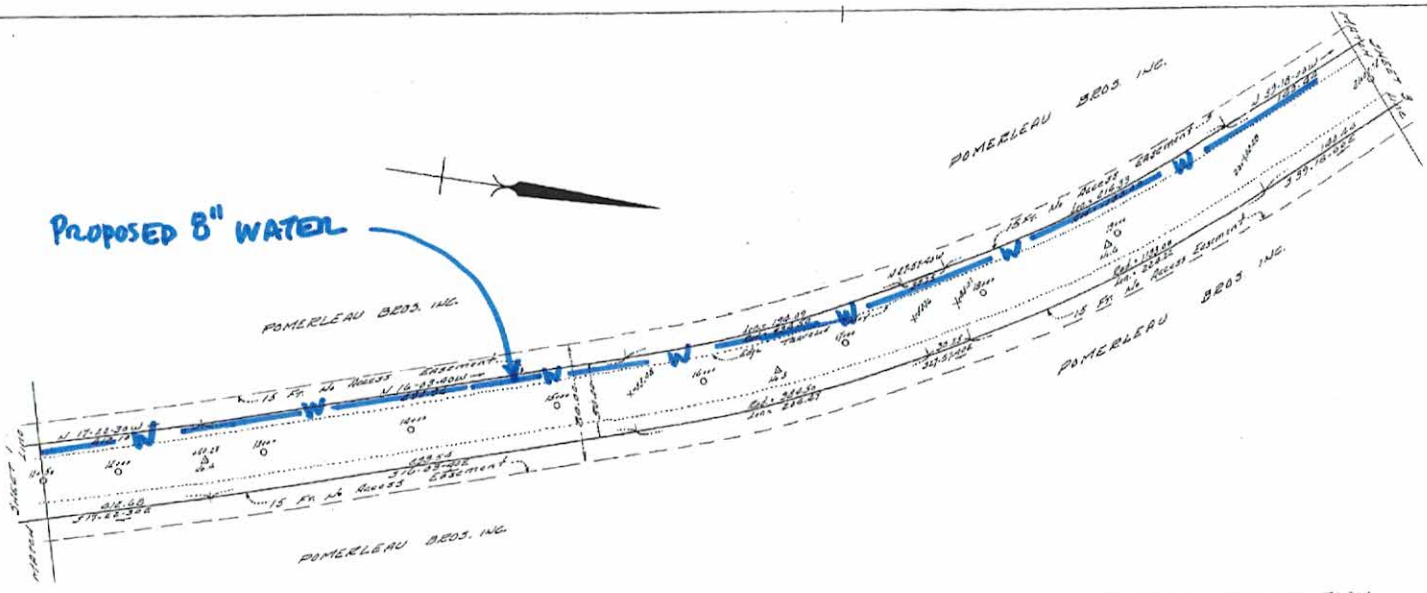

PLAN NUMBER 1044 (3/26) 1976  
RECORRED BOOK 35A59 PAGE 630

RICHARD L. MAGLIMERY  
AUGUST 4, 1975



ROAD LAYOUT PLAN  
IN  
GROTON, MASS.  
LAID OUT FOR THE  
TOWN OF GROTON  
SCALE 1/4" = 40 FT.

APPROVAL UNDER SUBDIVISION  
CONTROL LAW NOT REQUIRED

Henry S. McMillan  
Douglas L. James  
Joseph C. Lavin

SHEET 2 OF 5

March 30, 1976

1044-V

215 @ B

2/5

PRIVATE WAY - GROTON

Proposed 8" WATER



ISAAC L. HALL

LEONARD & NATHALIE POETSKY

NO ACCESS EASEMENT, VARIABLE WIDTHS  
JOHN J. CENNIN

NO ACCESS EASEMENT, VARIABLE WIDTHS  
JOHN J. CENNIN

N 63-33-44E  
164.23

N 31-28-55E  
161.48

JOHN J. CENNIN

NO ACCESS EASEMENT

VARIABLE WIDTHS  
John J. Cennin

LEONARD & NATHALIE POETSKY

POMERLEAU BROS. INC.

PLAN NUMBER 1244 (Cor-5) OF 1926  
RECORDED, BOOK 13,653, PAGE 90

RICHARD L. MULLINCHY  
AUGUST 5, 1975



*Richard L. Mullinchy*

ROAD LAYOUT PLAN  
OF  
GROTON, MASS.  
LAID OUT FOR THE  
TOWN OF GROTON  
SCALE 1/4" = 60' 0"

APPROVAL UNDER SUBDIVISION  
CONTROL LAW NOT REQUIRED

*Henry S. Miller Jr.*  
*Douglas L. James*  
*Joseph P. Leman*

SHEET 3 OF 5

March 30, 1976

2150C

104423

3/5


PRIVATE WAY - GROTON

PROPOSED 8" WATER



LEONARD & NATHALIE POBETSKY

JOHN J. CROVIN, NO ACCESS EASEMENT, VARIABLE WIDTHS

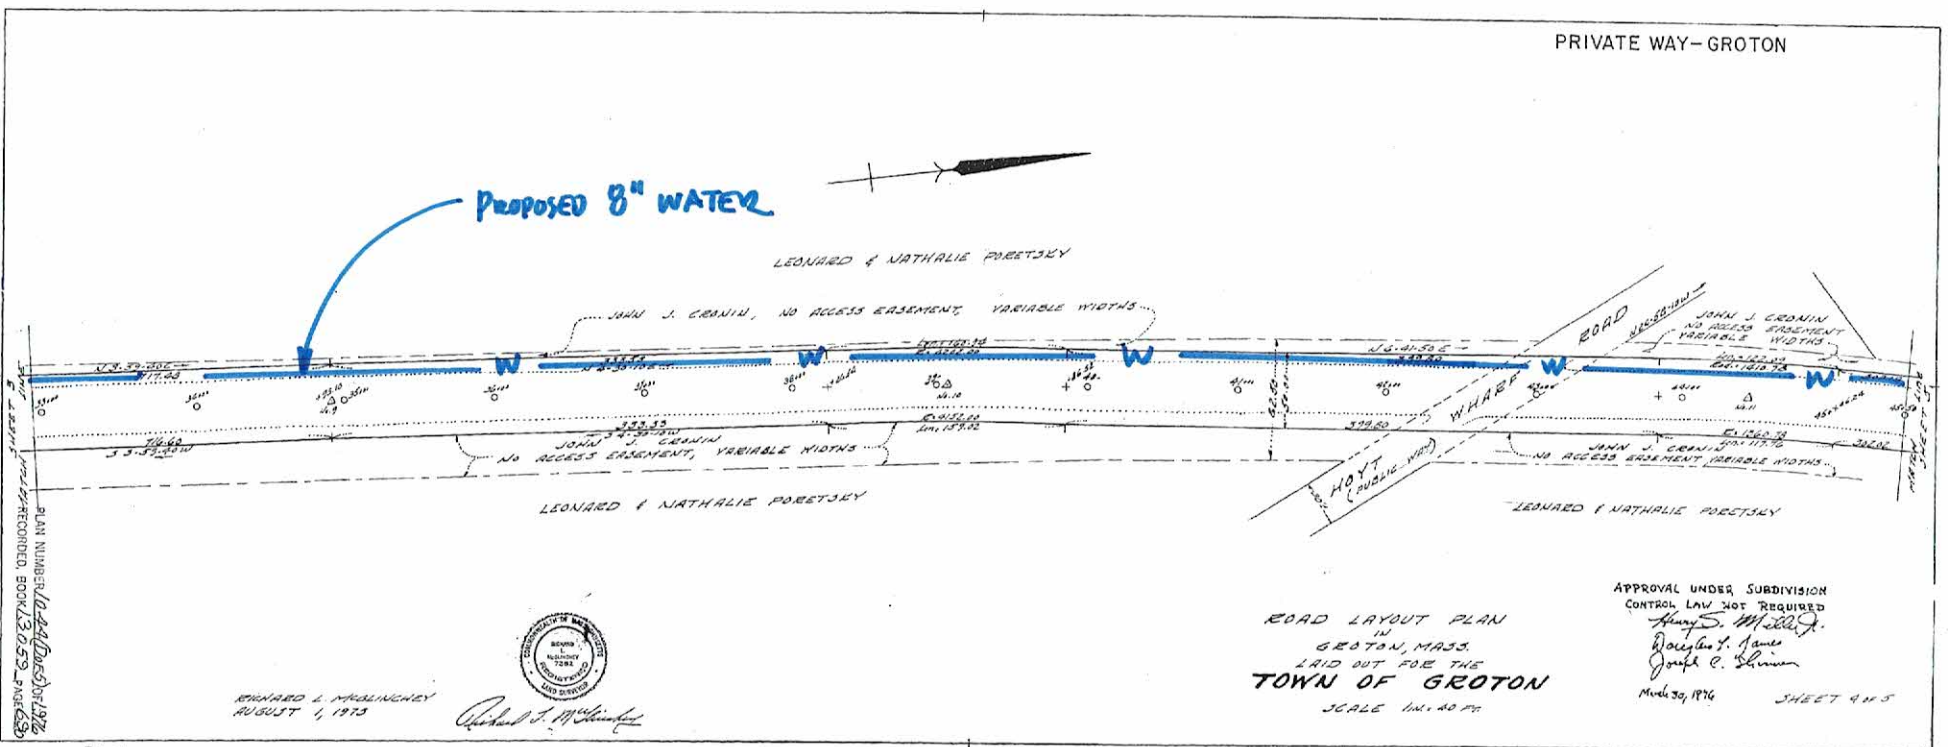


LEONARD & NATHALIE POBETSKY

LEONARD & NATHALIE POBETSKY

PLAN NUMBER 1044 (6) OF 1972  
RECORDED, BOOK 13053, PAGE 63

EDWARD L. MALLINCHENY  
AUGUST 4, 1973

*Richard J. Mallincheny*

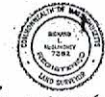

ROAD LAYOUT PLAN  
IN  
GROTON, MASS.  
LAID OUT FOR THE  
TOWN OF GROTON  
SCALE 1/4" = 40' 0"

APPROVAL UNDER SUBDIVISION  
CONTROL LAW NOT REQUIRED

*Henry S. Miller*  
*Douglas F. James*  
*Joseph C. Shuman*

MASS. REG. 1976


SHEET 4 OF 5

31.1 0

1044-4

4/5

PROPOSED 8" WATER LINE

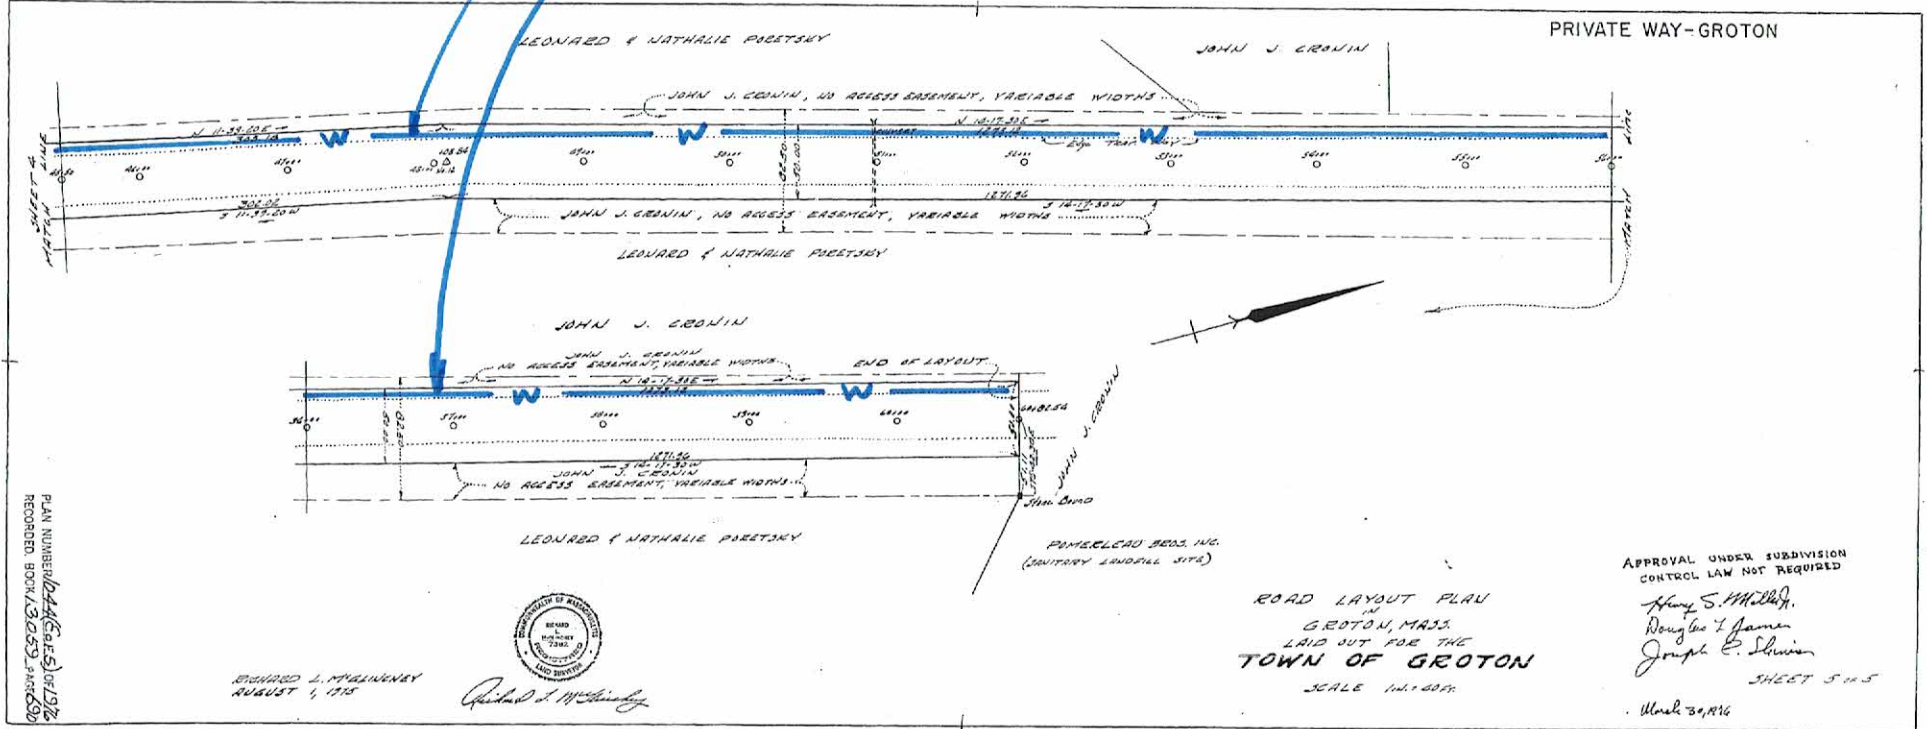

PLAN NUMBER 244 (Case) of 1915  
RECORDED BOOK 3,053 PAGE 630

RICHARD J. McQUINN  
AUGUST 1, 1915

REGISTRAR OF DEEDS  
TOWN OF GROTON  
MASSACHUSETTS  
LAND OFFICE

*Richard J. McQuinn*

ROAD LAYOUT PLAN  
IN  
GROTON, MASS.  
LAID OUT FOR THE  
TOWN OF GROTON  
SCALE 1/4" = 60'

APPROVAL UNDER SUBDIVISION  
CONTROL LAW NOT REQUIRED

*Henry S. McCallister*  
*Douglas L. James*  
*Joseph E. Shivers*

SHEET 5 OF 5  
March 30, 1916

1044-5

5/5