



FLORENCE ROCHE
ELEMENTARY SCHOOL
342 Main Street
Groton, MA 01450




NOTE:
All as built information was gathered
using the control points provided. We
do not guarantee the locations
provided on this plan and only
represent that dimensions and
locations shown are relative to the
control points provided.

SHEET AB-FPS.D1
FINAL PROPERTY SURVEY (DRAIN)

Date: 2/28/2025		
Drawn by: MAC		
Revisions:		
Rev #	Date	Revision By
#1	4/17/2025	

Scale: 1" = 30'



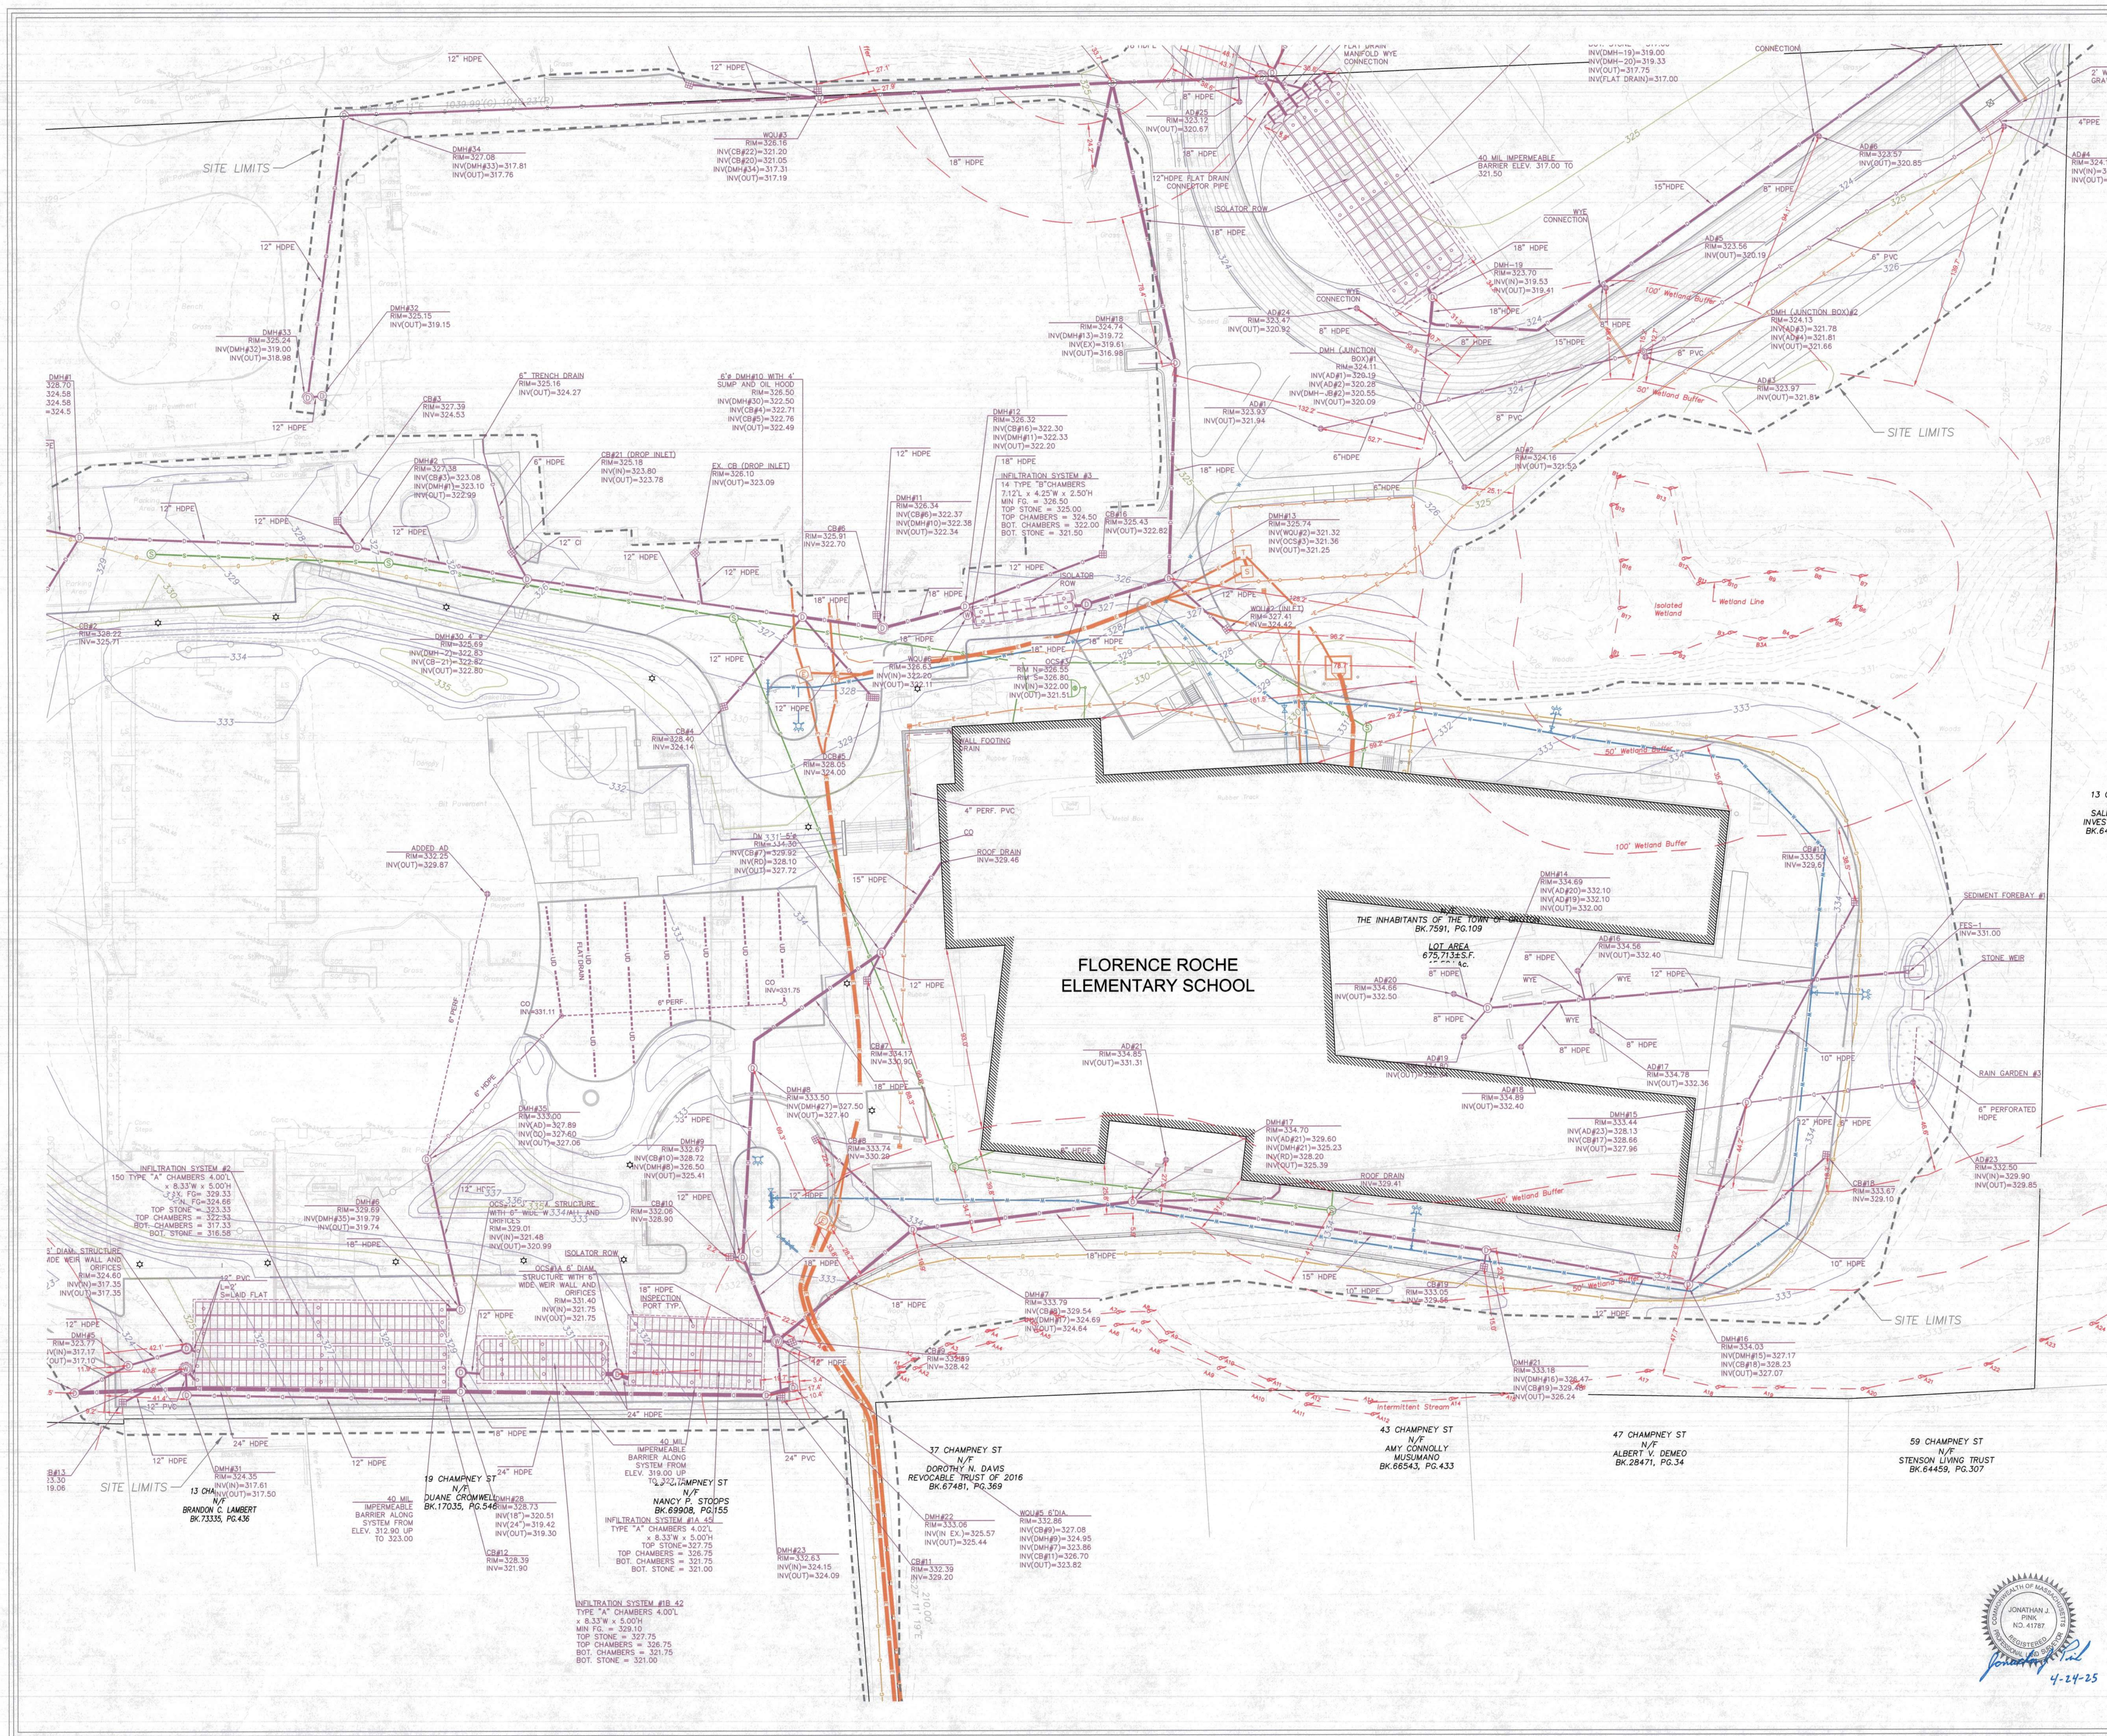


FLORENCE ROCHE
ELEMENTARY SCHOOL
342 Main Street
Groton, MA 01450




NOTE:
All as built information was gathered
using the control points provided. We
do not guarantee the locations
provided on this plan and only
represent that dimensions and
locations shown are relative to the
control points provided.

SHEET AB-FPS.D2
FINAL PROPERTY SURVEY (DRAIN)

Date: 2/28/2025		
Drawn by: MAC		
Revisions:		
Rev #	Date	Revision By
1	4/17/2025	
Scale: 1" = 30'		

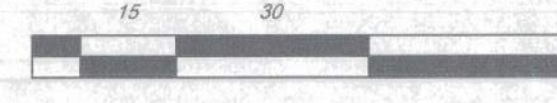

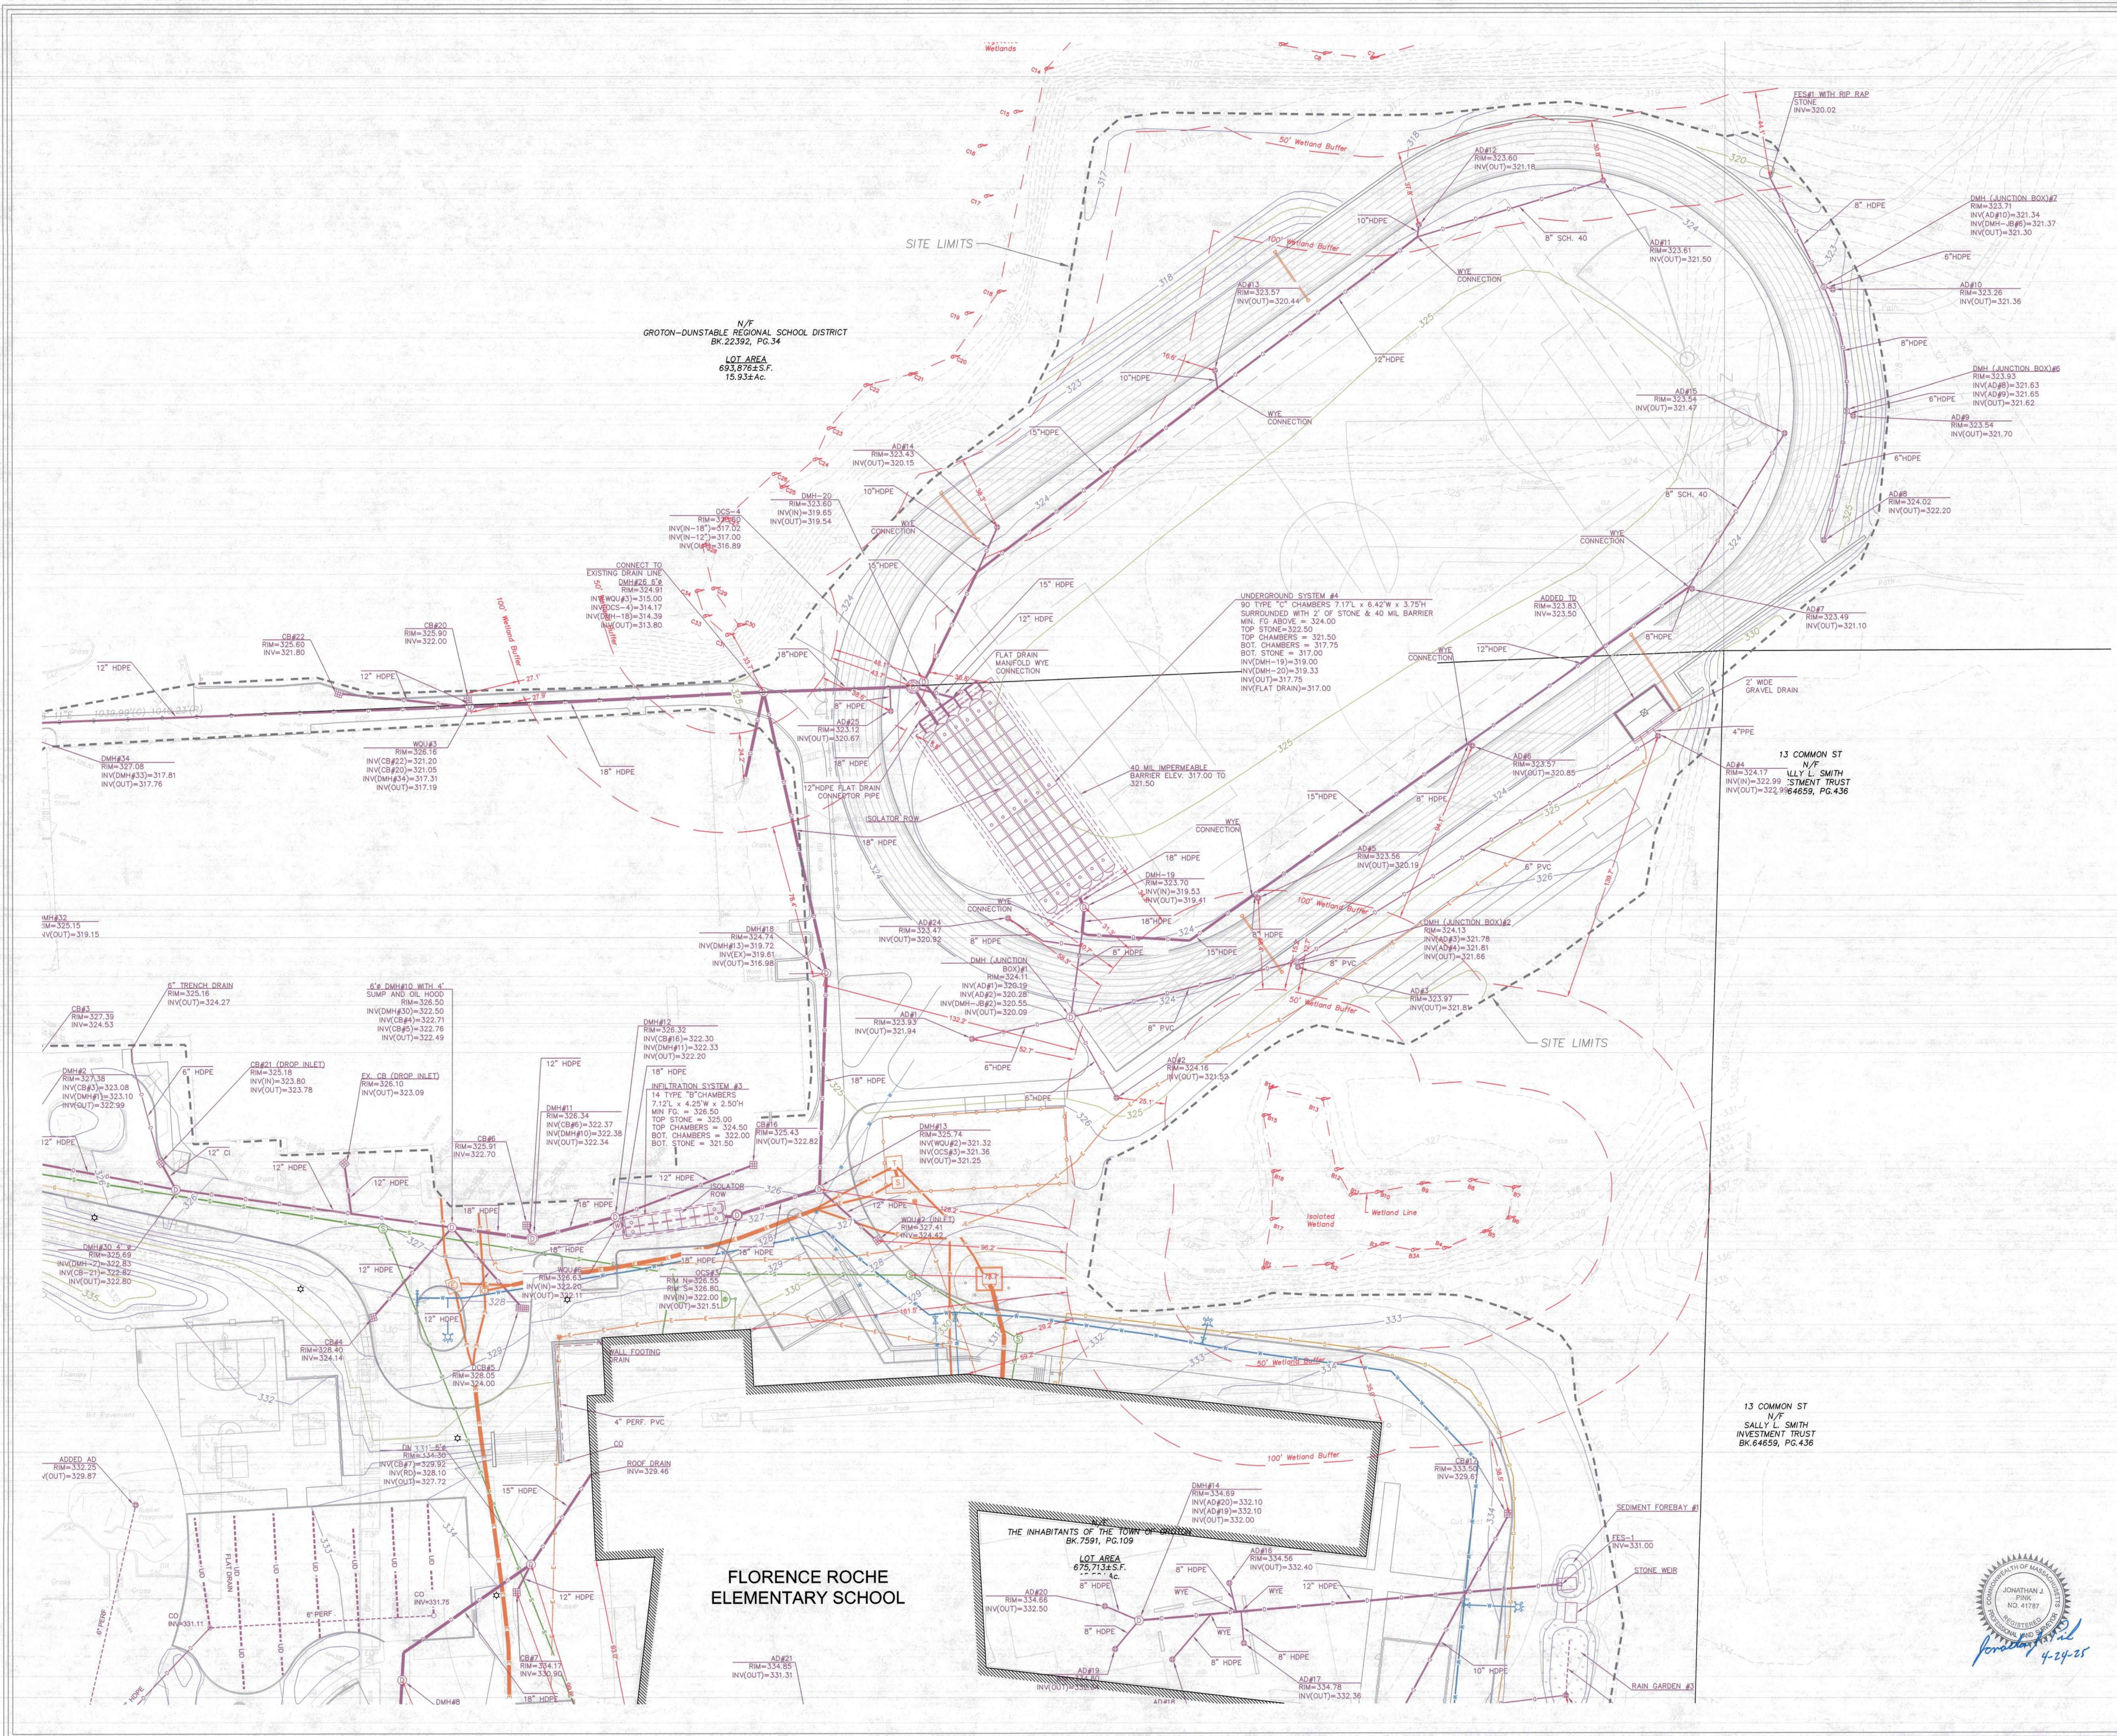


FLORENCE ROCHE
ELEMENTARY SCHOOL
342 Main Street
Groton, MA 01450




NOTE:
All as built information was gathered using the control points provided. We do not guarantee the locations provided on this plan and only represent that dimensions and locations shown are relative to the control points provided.

SHEET AB-FPS.D3
FINAL PROPERTY SURVEY (DRAIN)

Date: 2/28/2025		
Drawn by: MAC		
Revisions:		
Rev #	Date	Revision By
#1	4/17/2025	

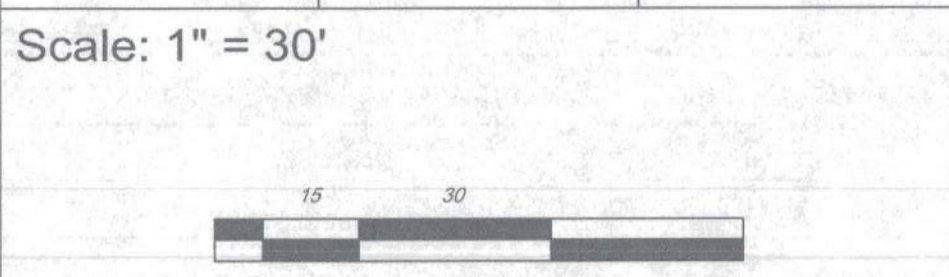

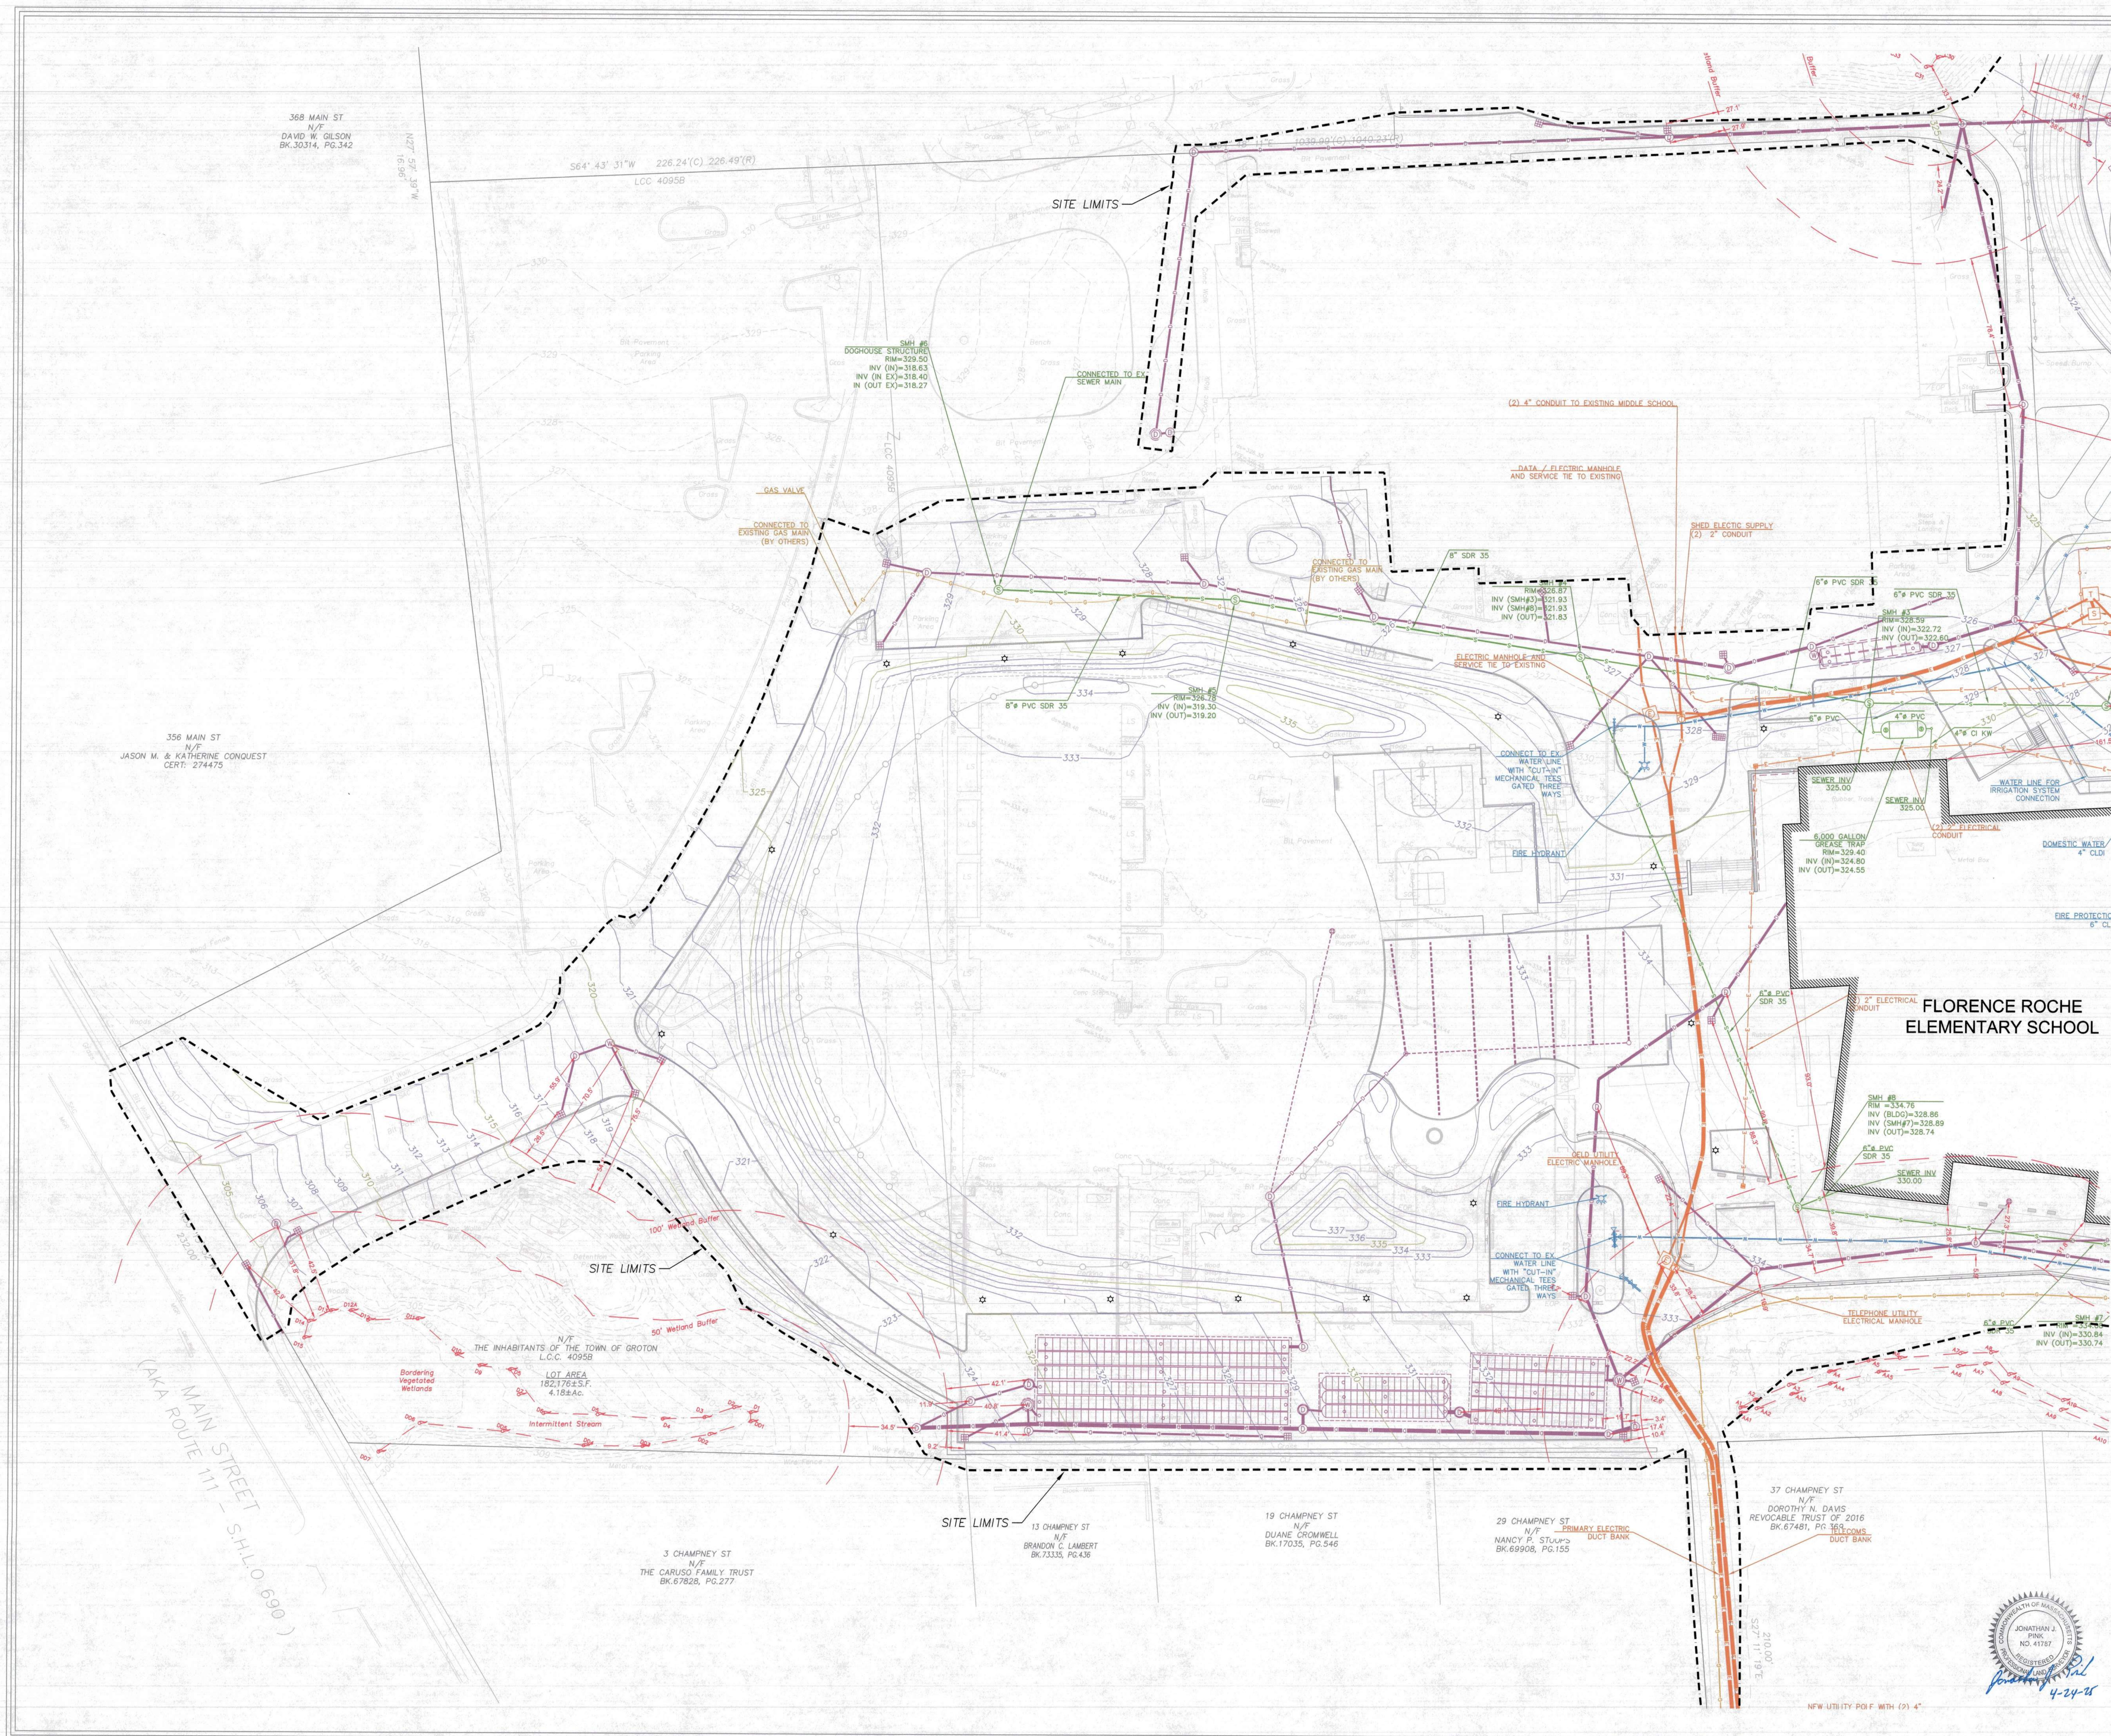

FLORENCE ROCHE
ELEMENTARY SCHOOL
342 Main Street
Groton, MA 01450




NOTE:
All as built information was gathered
using the control points provided. We
do not guarantee the locations
provided on this plan and only
represent that dimensions and
locations shown are relative to the
control points provided.

SHEET AB-FPS.U1

FINAL PROPERTY SURVEY (UTIL)

Date: 2/28/2025		
Drawn by: MAC		
Revisions:		
Rev #	Date	Revision By
#1	4/17/2025	

Scale: 1" = 30'

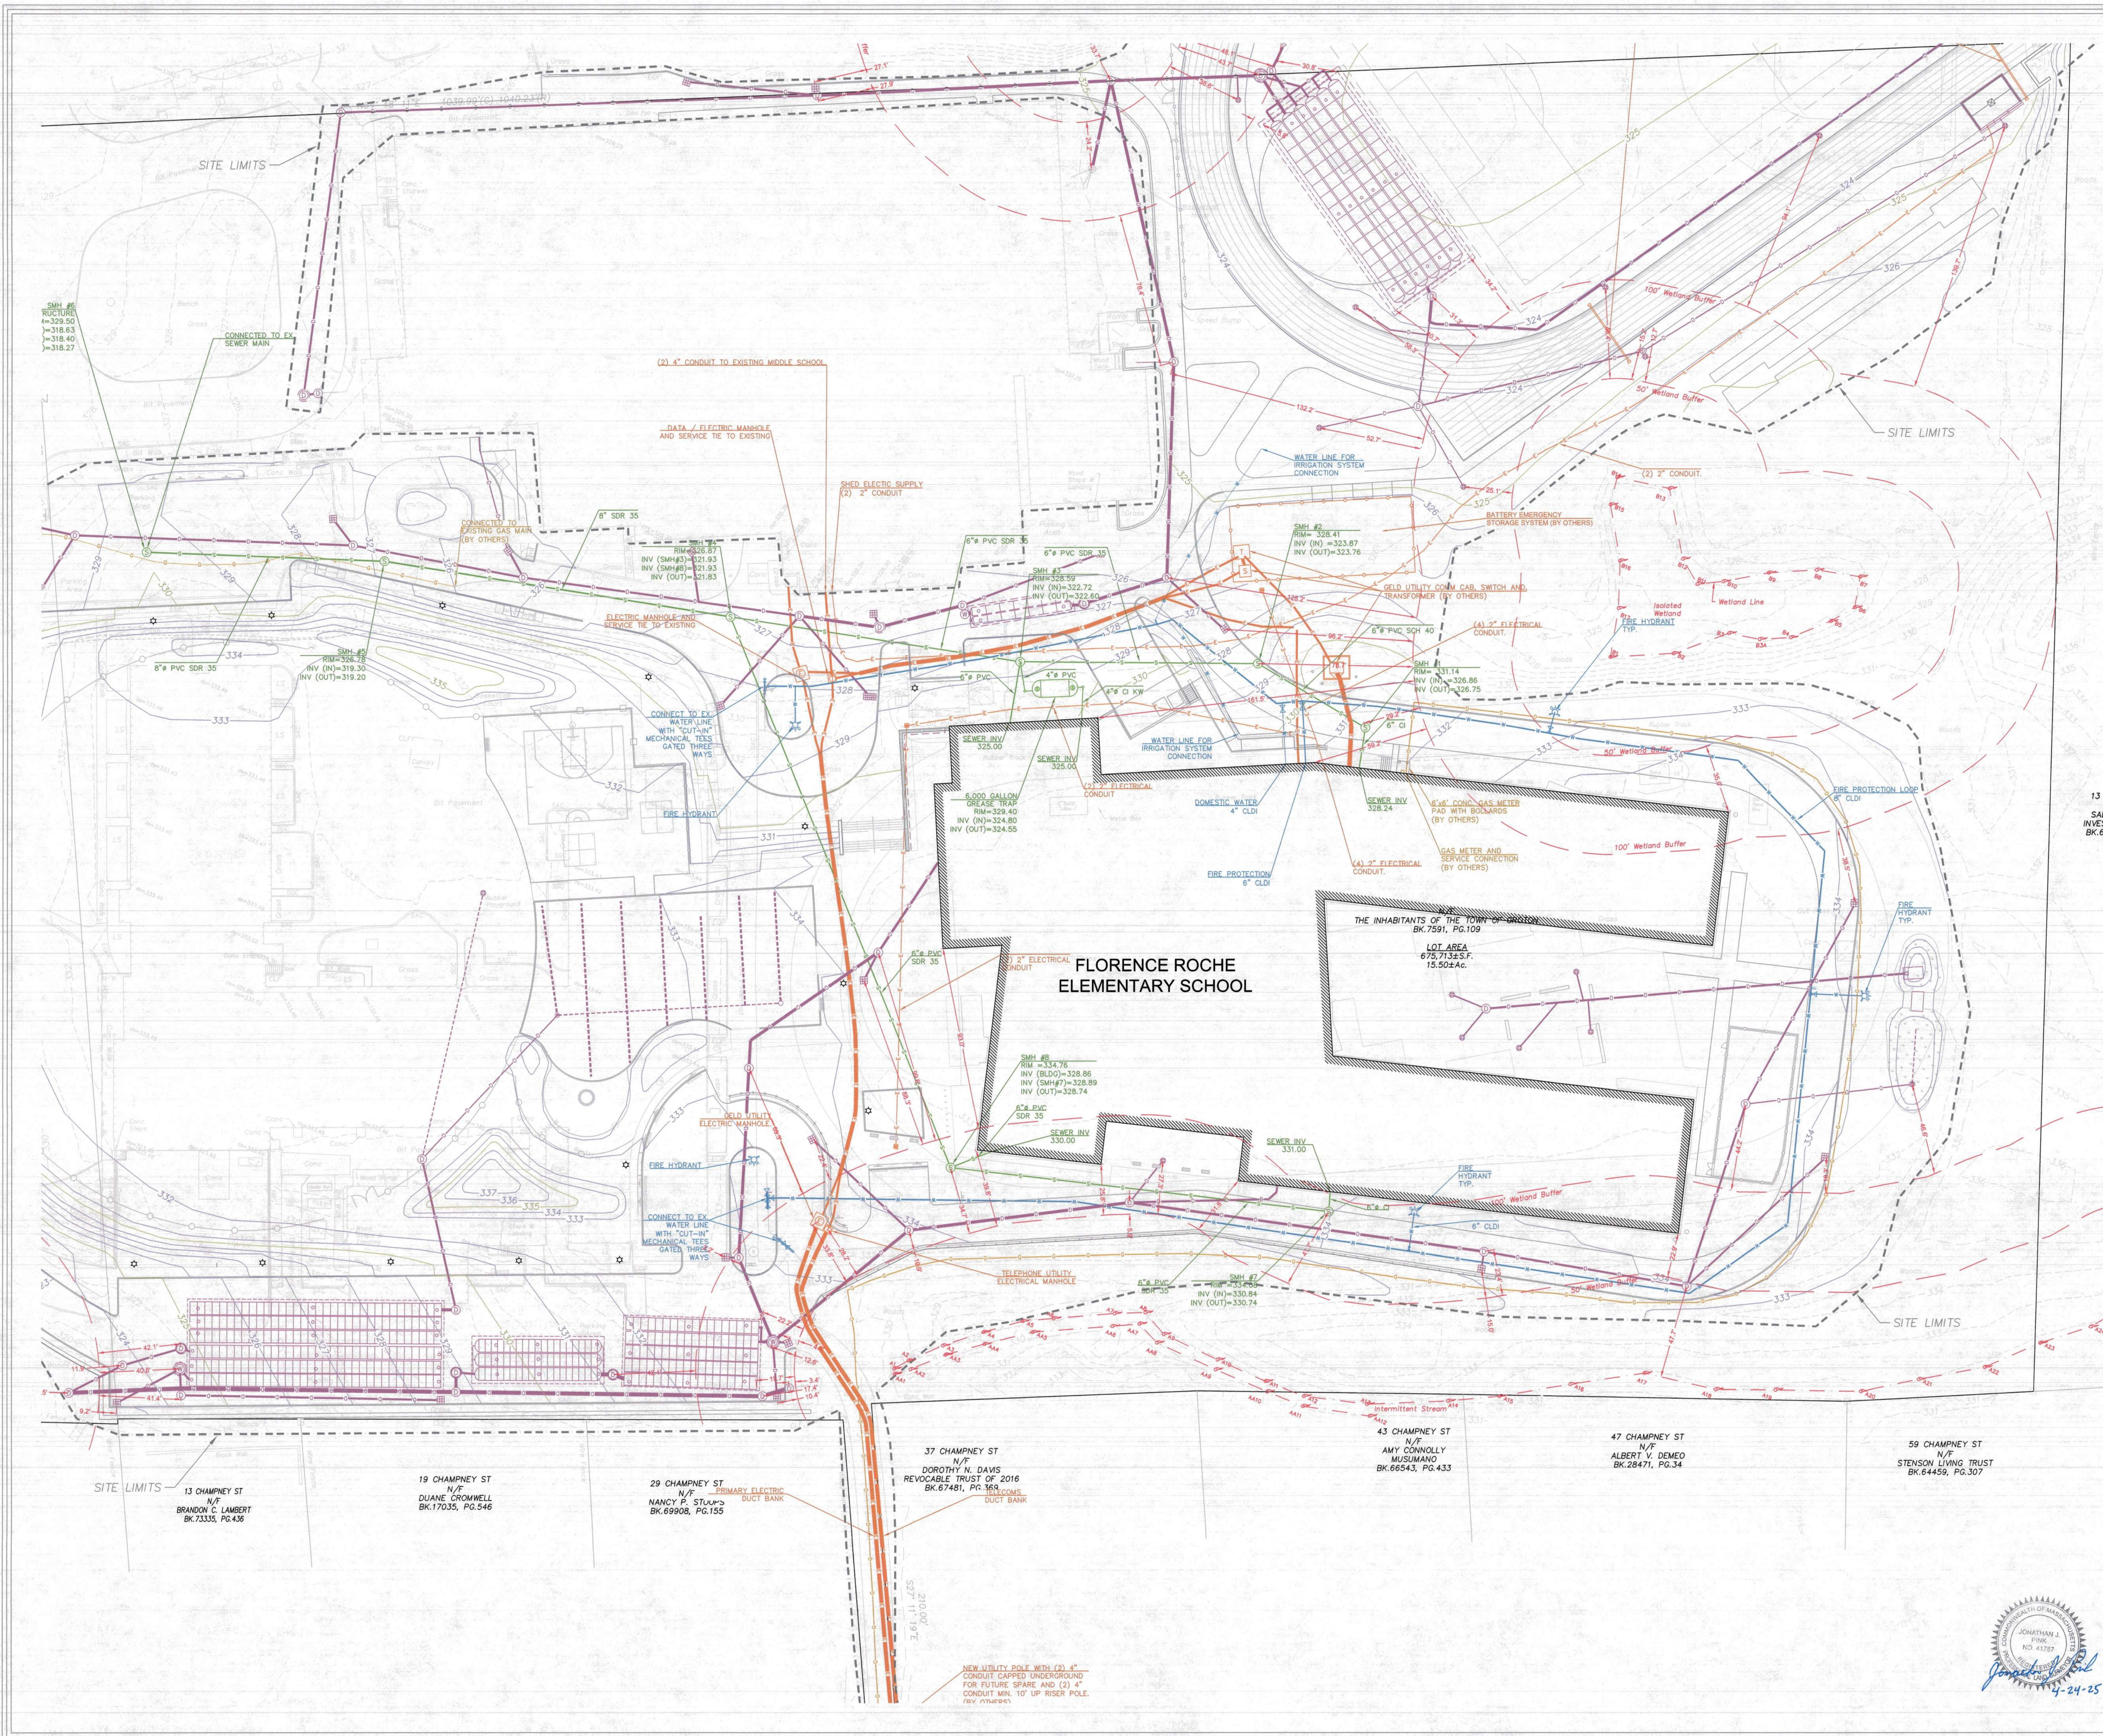

FLORENCE ROCHE
ELEMENTARY SCHOOL
342 Main Street
Groton, MA 01450




NOTE:
All as built information was gathered
using the control points provided. We
do not guarantee the locations
provided on this plan and only
represent that dimensions and
locations shown are relative to the
control points provided.

SHEET AB-FPS.U2
FINAL PROPERTY SURVEY (UTIL)

Date: 2/28/2025		
Drawn by: MAC		
Revisions:		
Rev #	Date	Revision By
#1	4/17/2025	

Scale: 1" = 30'



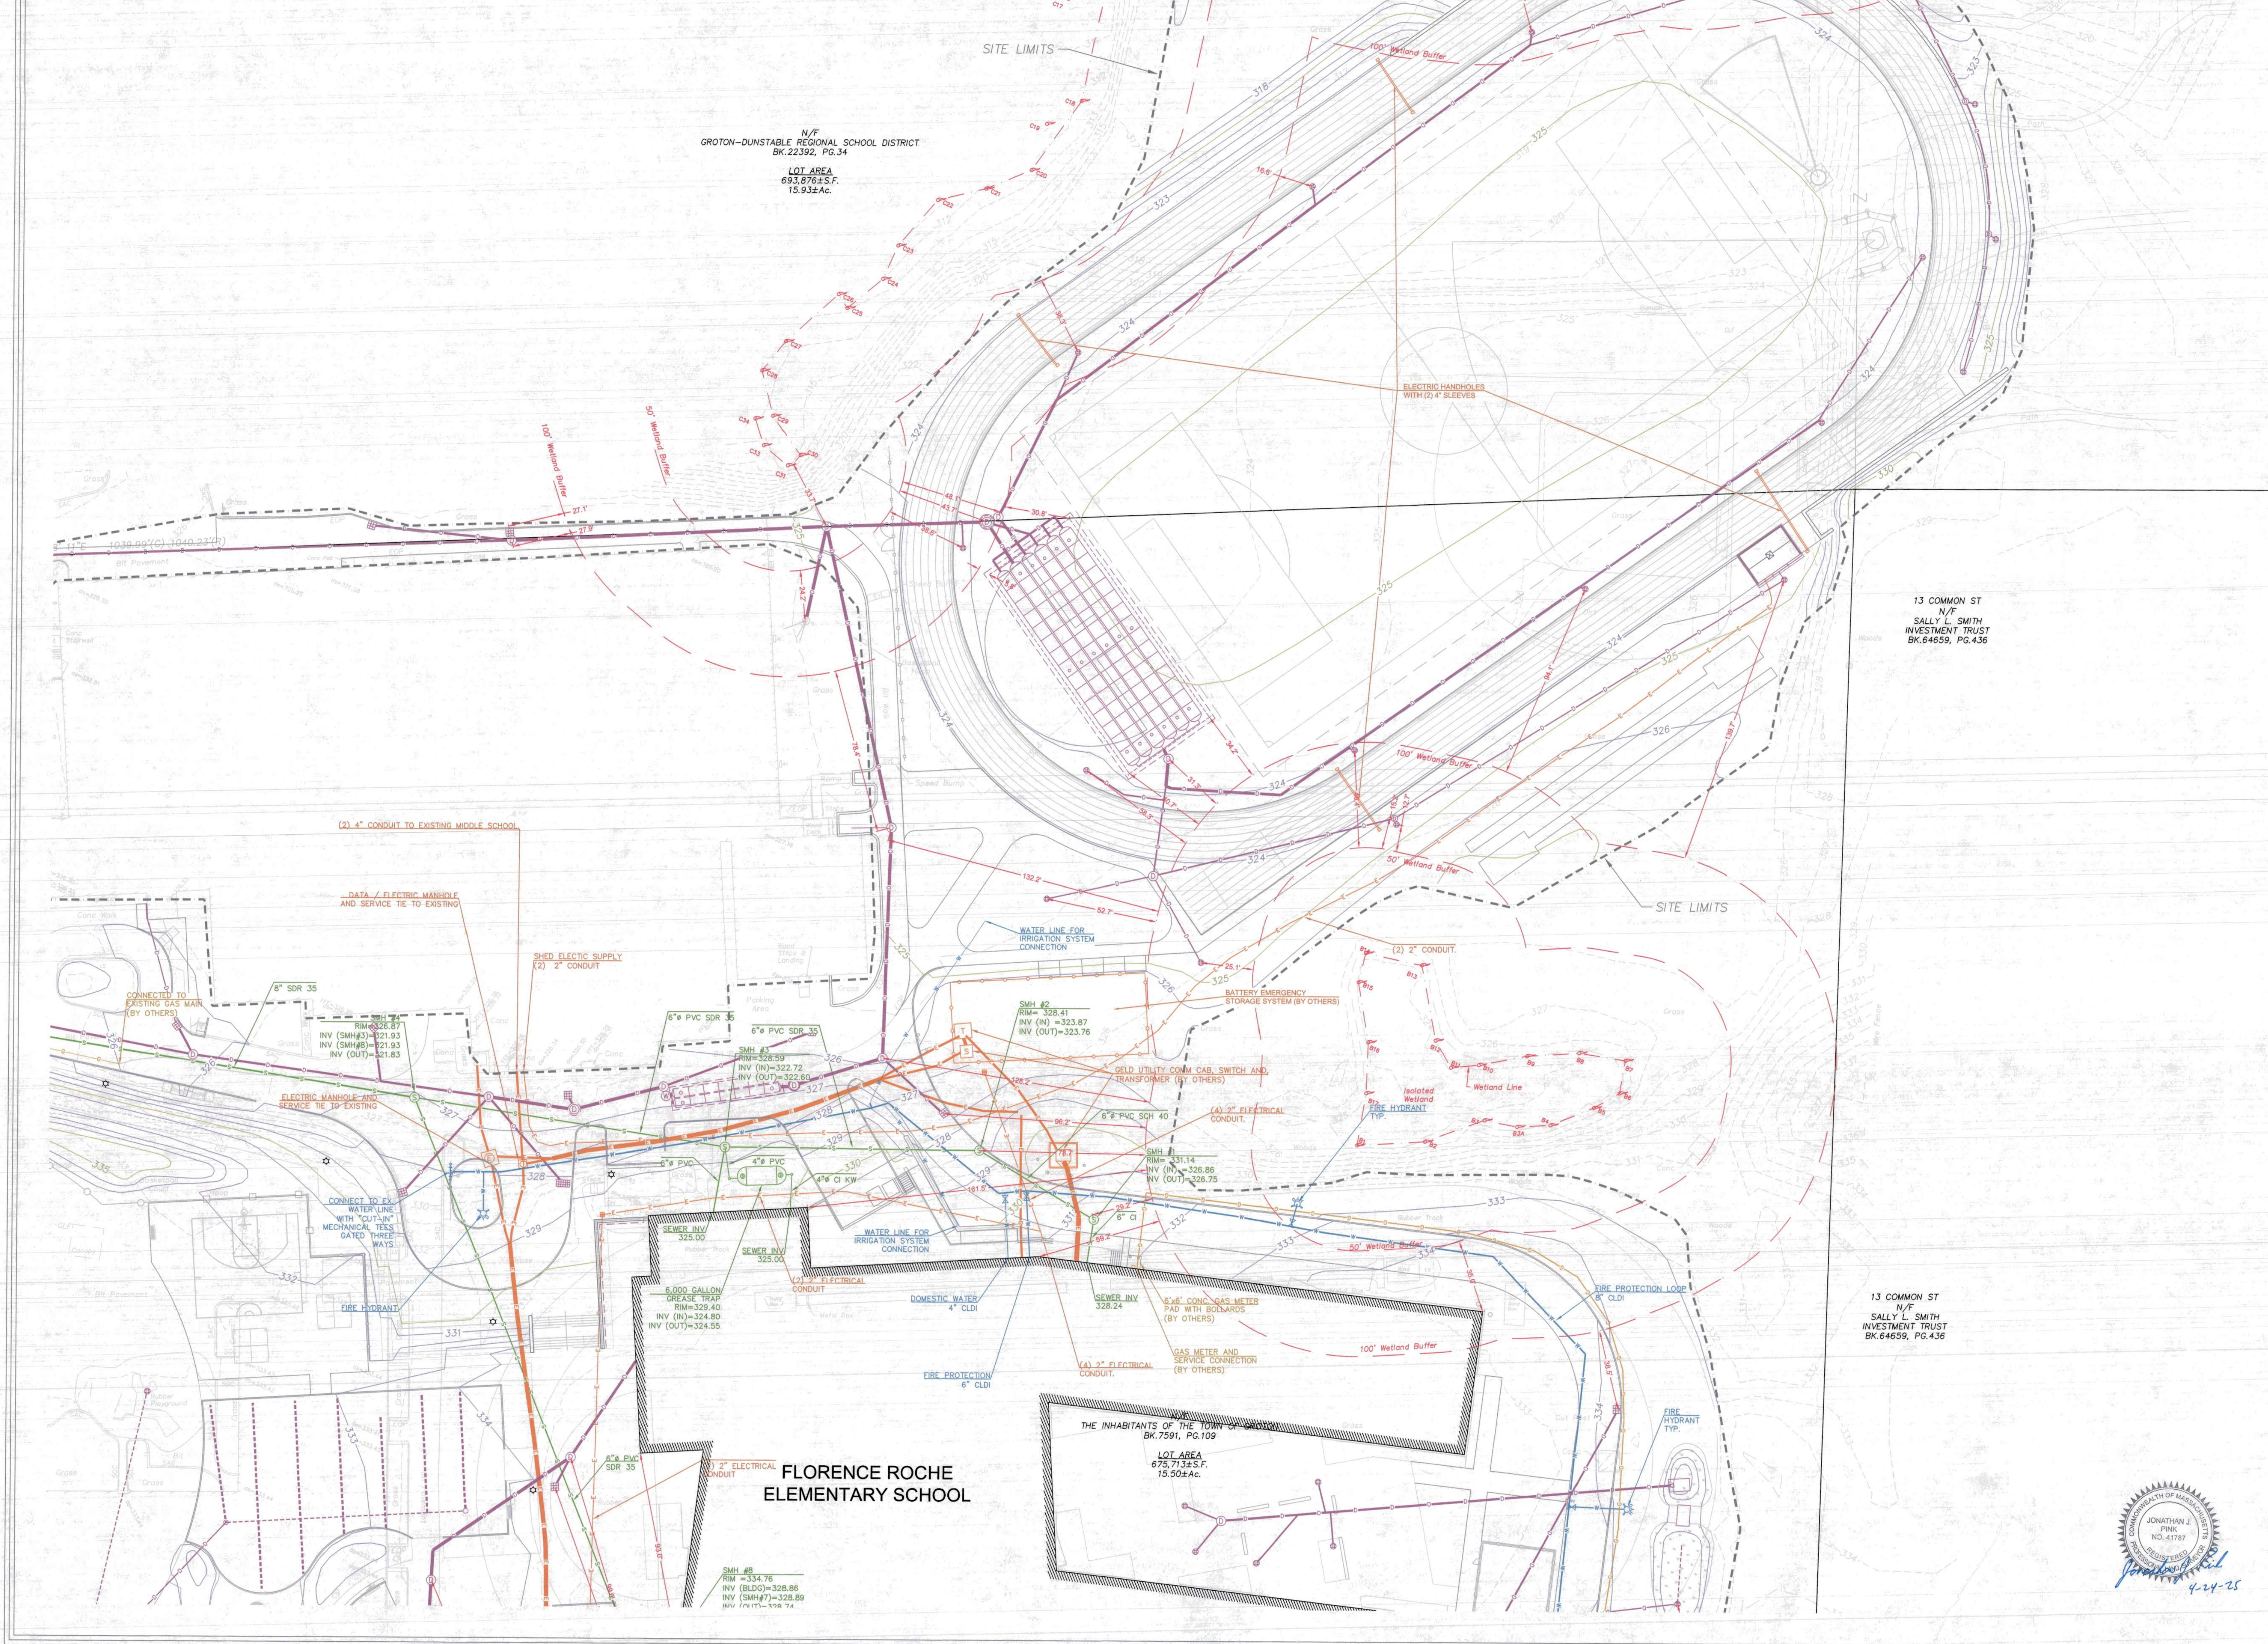

FLORENCE ROCHE
ELEMENTARY SCHOOL
342 Main Street
Groton, MA 01450



NOTE:
All as built information was gathered
using the control points provided. We
do not guarantee the locations
provided on this plan and only
represent that dimensions and
locations shown are relative to the
control points provided.

SHEET AB-FPS.U3
FINAL PROPERTY SURVEY (UTIL)

Date: 2/28/2025		
Drawn by: MAC		
Revisions:		
Rev #	Date	Revision By
#1	4/17/2025	

Scale: 1" = 30'

